






EXISTING SIGNS

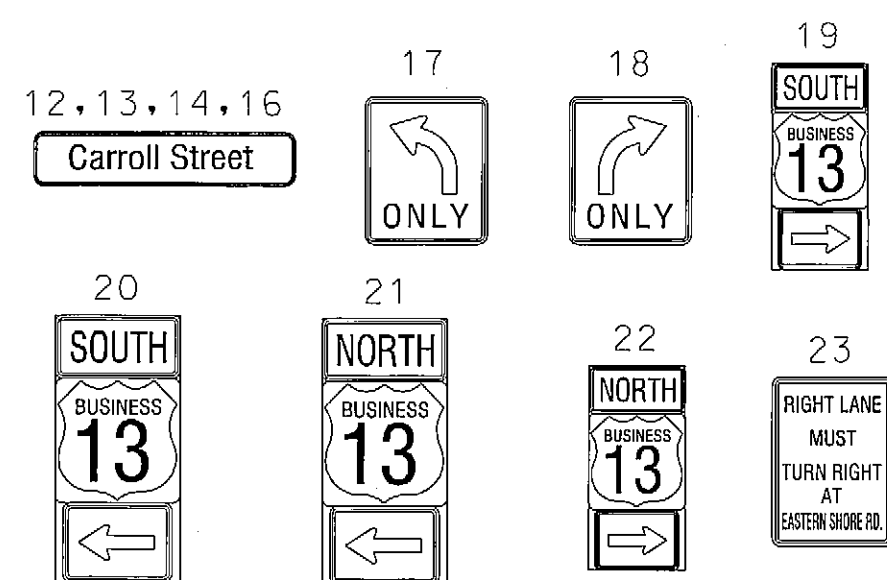


EXISTING LED SIGN

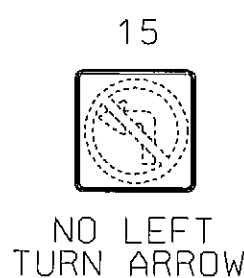


EXISTING SIGNALS

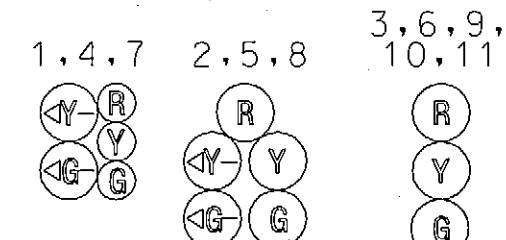


EXISTING VIDEO DETECTION CAMERA

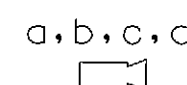


EXISTING OPTICOM DETECTOR

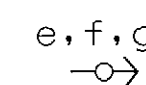

NEMA PHASING

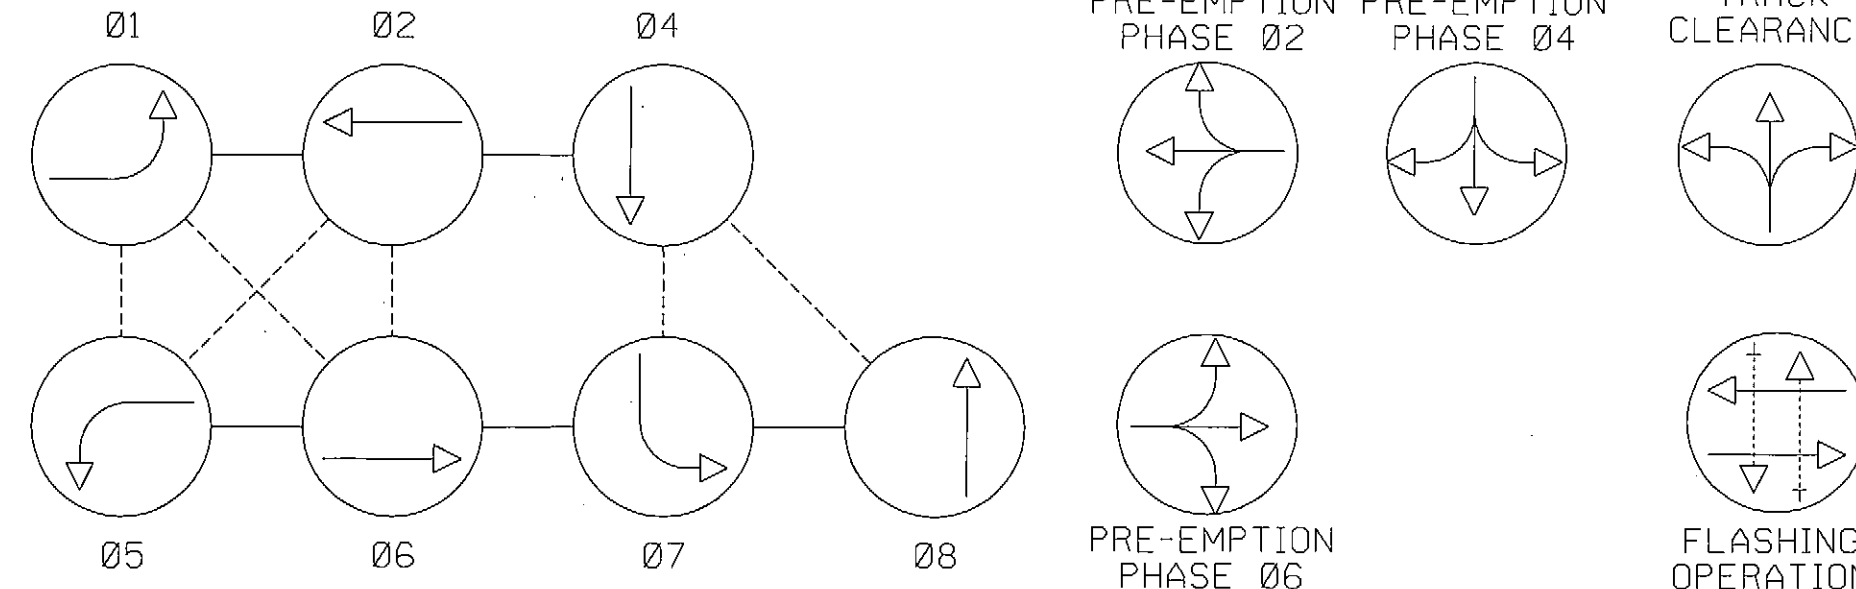


NOTE:
PHASES ASSOCIATED BY A DASHED LINE WILL OPERATE CONCURRENTLY.
PHASES ASSOCIATED BY A SOLID LINE WILL NOT OPERATE CONCURRENTLY.

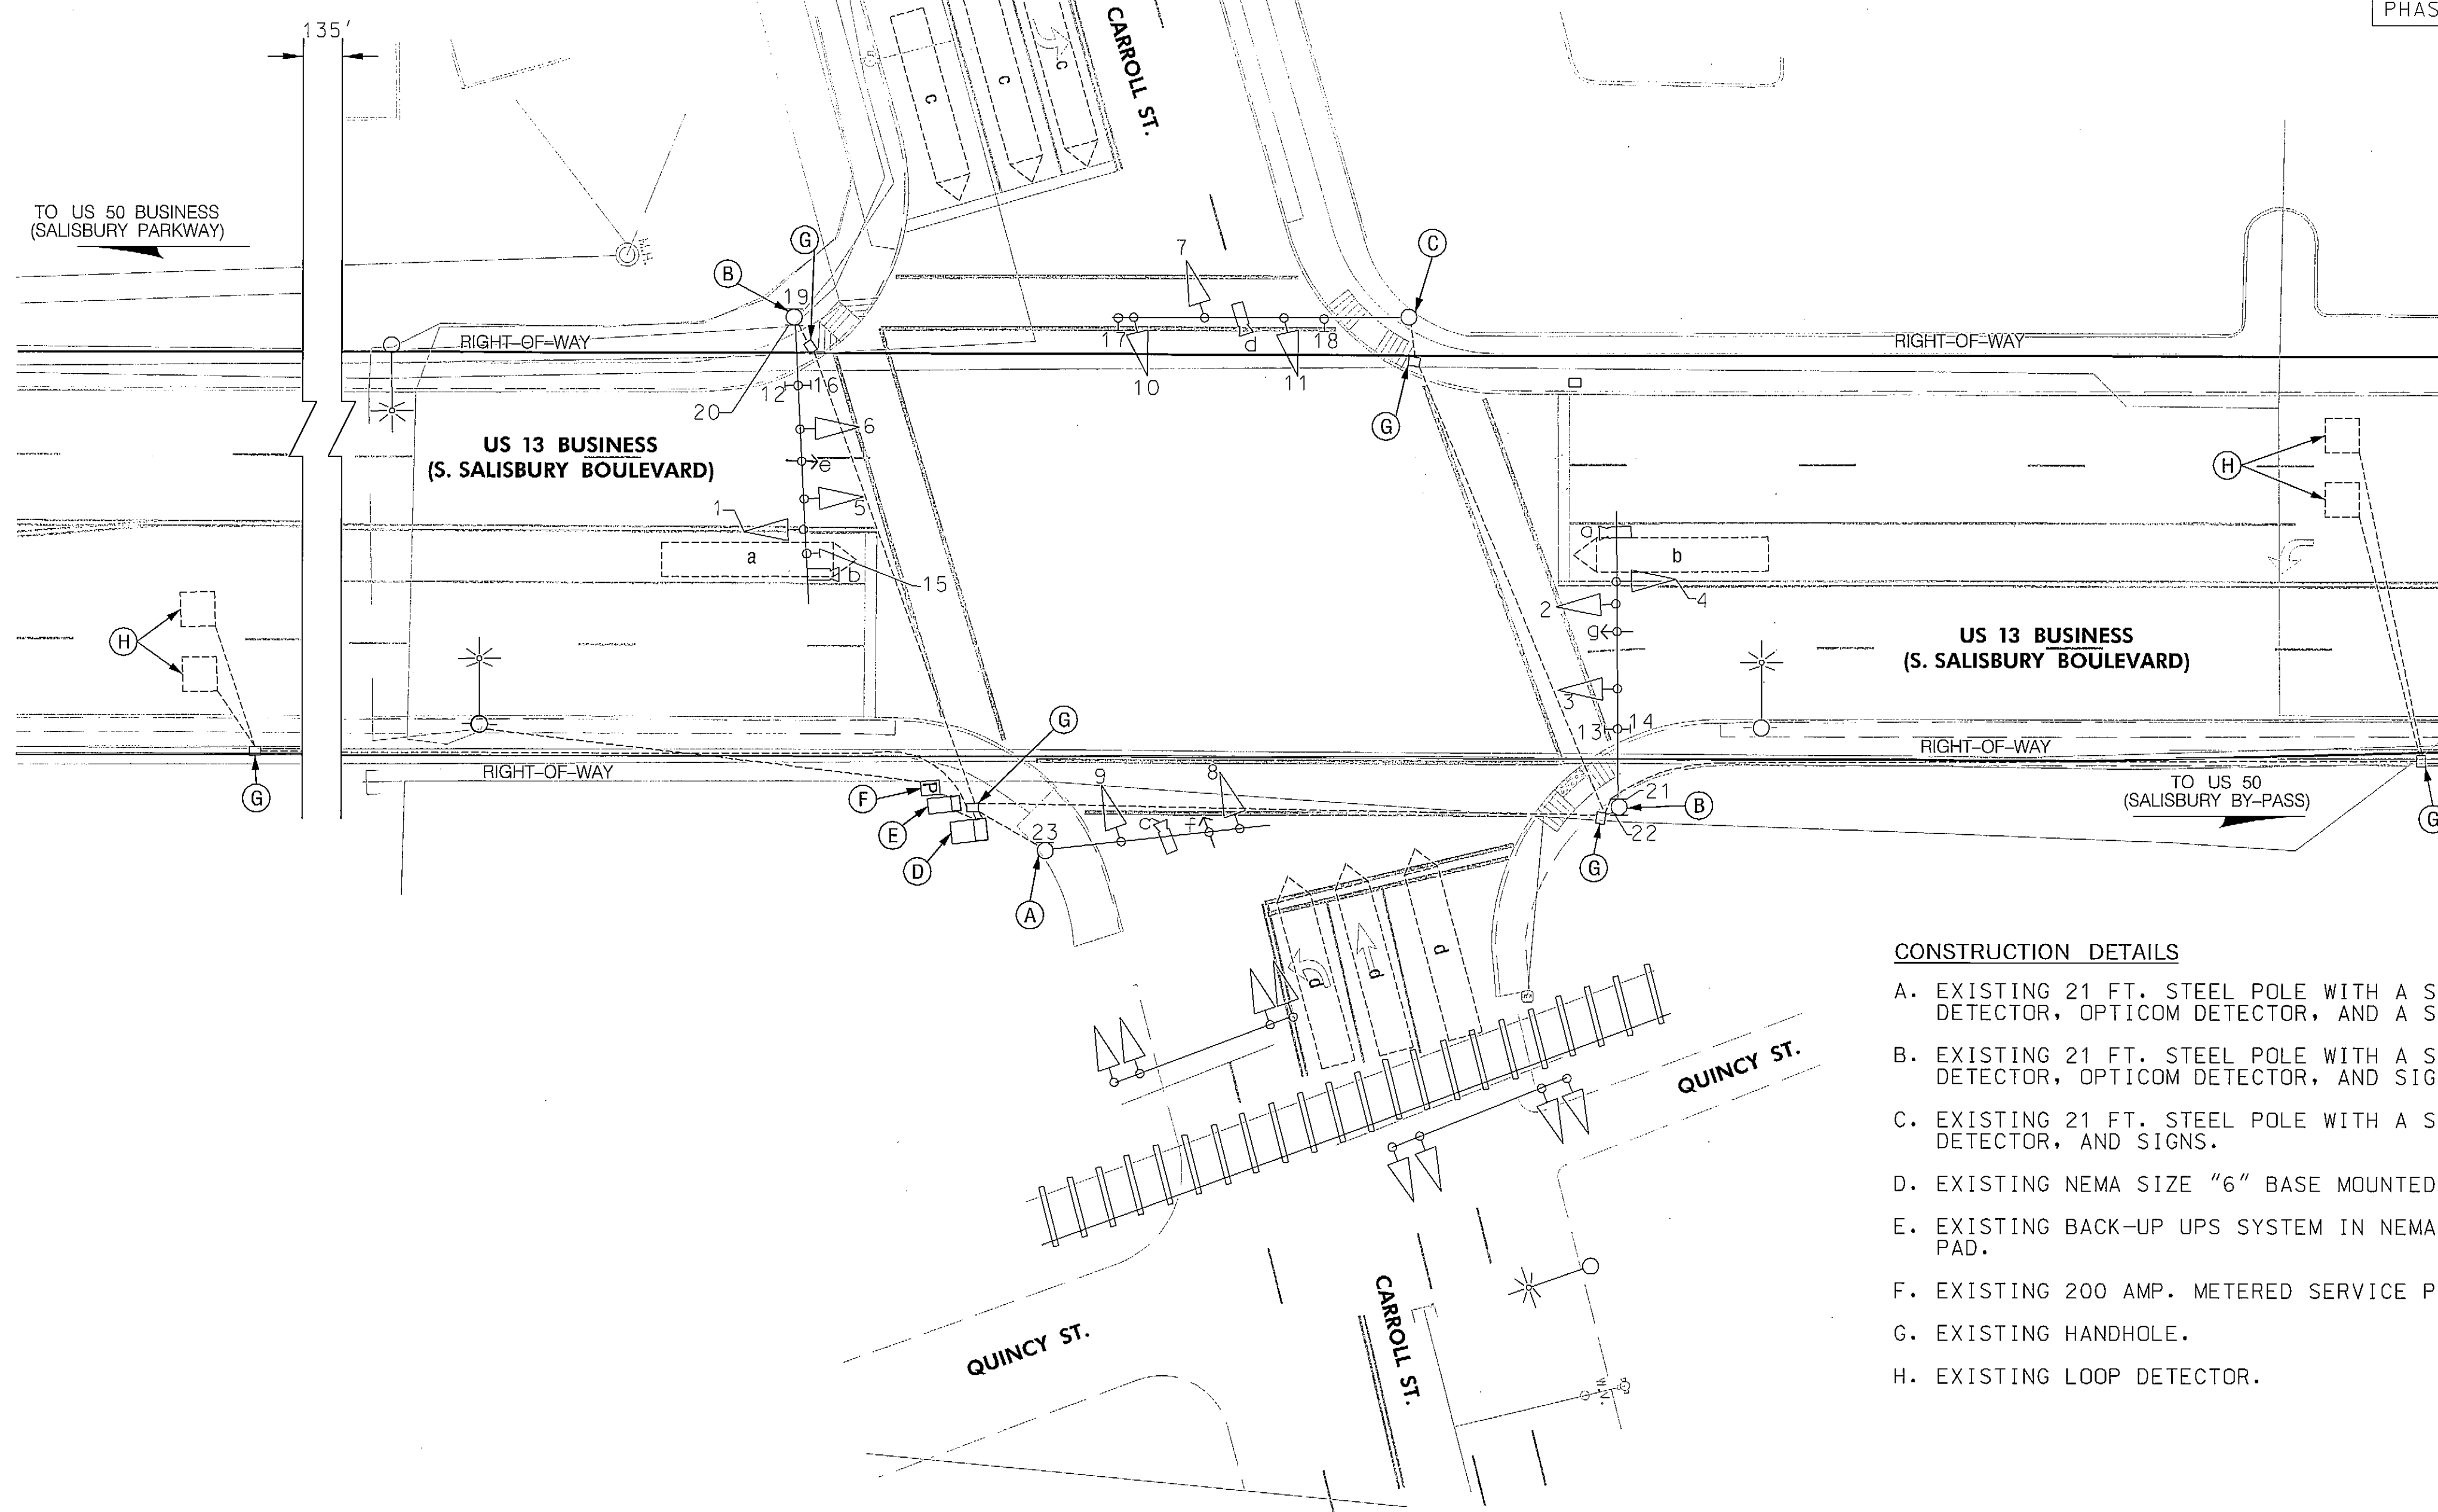

CONSTRUCTION DETAILS

- A. EXISTING 21 FT. STEEL POLE WITH A SINGLE MAST ARM, TRAFFIC SIGNAL HEADS, VIDEO CAMERA DETECTOR, OPTICOM DETECTOR, AND A SIGN.
- B. EXISTING 21 FT. STEEL POLE WITH A SINGLE MAST ARM, TRAFFIC SIGNAL HEADS, VIDEO CAMERA DETECTOR, OPTICOM DETECTOR, AND SIGNS.
- C. EXISTING 21 FT. STEEL POLE WITH A SINGLE MAST ARM, TRAFFIC SIGNAL HEADS, VIDEO CAMERA DETECTOR, AND SIGNS.
- D. EXISTING NEMA SIZE "6" BASE MOUNTED CABINET AND CONTROLLER WITH CONCRETE PAD.
- E. EXISTING BACK-UP UPS SYSTEM IN NEMA SIZE "5" BASE MOUNTED CABINET WITH CONCRETE PAD.
- F. EXISTING 200 AMP. METERED SERVICE PEDESTAL.
- G. EXISTING HANDHOLE.
- H. EXISTING LOOP DETECTOR.

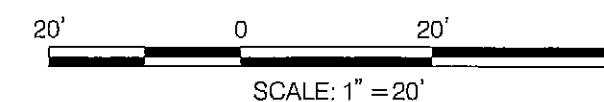

GEOMETRIC LEGEND

EXISTING

UTILITY LEGEND

- SD — SD — STORM DRAIN
- G — G — GAS MAIN
- W — W — WATER MAIN
- S — S — SEWER MAIN
- E — E — ELECTRIC CABLES
- A — A — AERIAL CABLES
- T — T — TELEPHONE CABLES
- F — F — FIBER-OPTIC



SABRA, WANG & ASSOCIATES, INC.
1504 JOH AVENUE
SUITE 180
BALTIMORE, MD 21117
(410) 737-6564
WWW.SABRA-WANG.COM

APPROVALS	
TEAM LEADER	
ASST. DIV. CHIEF	
DIVISION CHIEF	
OFFICE DIRECTOR	

REVISIONS	
1	ASBUILT FOR UPS INSTALLATION
2	INSTALL APP AND CPS ACROSS ALL FOUR LEGS OF THE INTERSECTION
3	INSTALL CABINET AND CONTROLLER
4	INSTALL VIDEO DETECTION CAMERAS
5	INSTALL VIDEO DETECTION CAMERAS

SHA STATE OF MARYLAND
DEPARTMENT OF TRANSPORTATION
STATE HIGHWAY ADMINISTRATION
OFFICE OF TRAFFIC & SAFETY
TRAFFIC ENGINEERING DESIGN DIVISION
US 13 BUSINESS AND EAST CARROLL STREET
SALISBURY, MARYLAND

TRAFFIC SIGNAL PLAN

SCALE 1" = 20' ADVERTISED DATE 02/08/1984 CONTRACT NO. WL-633-502-185

DESIGNED BY _____ COUNTY WICOMICO
DRAWN BY THOMAS ZAYDEL LOGMILE 22B01305.27
CHECKED BY DENNIS DODA TMS NO. 1955
F.A.P. NO. _____ TOD NO. _____

TS NO. 1939E DRAWING — OF SHEET NO. 1 OF 2

PLOTTED: Friday, March 05, 2010 at 11:12:29 AM
FILE: psg-P000_US13_CARROLL ST(1839E).dgn